



NOTE  
1. FOR GENERAL NOTES SEE  
DRG R-H007-1

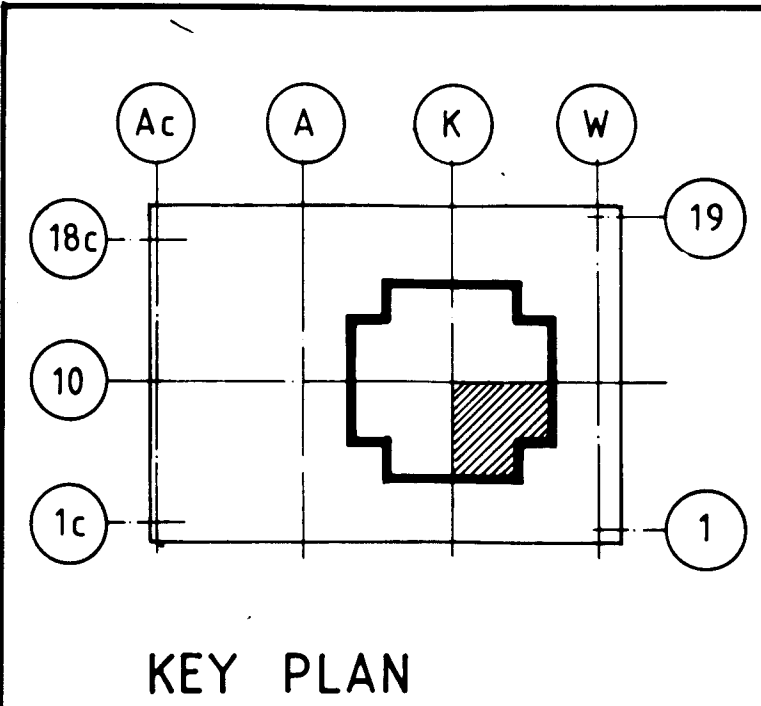

RECORD DRAWING

REVISION DATE DESCRIPTION  
**ONASSIS  
CARDIAC SURGERY CENTER**  
Joannou & Paraskevalides (soverasa) Ltd.  
civil engineering & building contractors

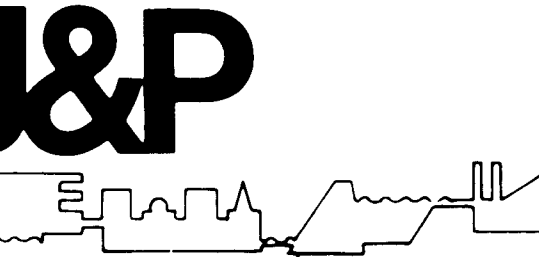

architects & health planners LLEWELYN-DAVIES WEEKS  
greek architects KAPSAMBELIS-STAMATIS  
structural & services engineers OVE ARUP & PARTNERS

TITLE  
DUCTWORK, LEVEL 6  
ZONE C

DRAWN BY	K.P.	DRAWING No	
DESIGN BY	M.S.		R-H007-3
CHECKED BY	N.P.		
SCALE	1:50	DATE	JULY 1991

H007-3