


GENERAL NOTES
1. FOR LEGEND OF SYMBOLS AND STANDARD NOTATIONS SEE DRG No R-H000-1

OPERATING THEATRE EXTRACT (AFF. 12)
1000x800 TA 530x360 AP L/L LEVEL 7
1000x800 FB
FD AT LEVEL 7 SLAB

TOILET EXTRACT TEF 1
300x250 TA 300x150 AP L/L LEVEL 7
300x200 FB
FD 300x250 AT LEVEL 7 SLAB

SEE SHAFT LAYOUT
DRG R-H041-16

TOILET EXTRACT TEF-1
300x400 TA 550x200 AP L/L LEVEL 7
FD AT LEVEL 7 SLAB
750x400 DUCT FB REDUCES BEFORE
LEVEL 6 FLOOR PENETRATION TO
700x350 FOR ACCOMMODATING WC CISTERN
AND PIPING ON LEVEL 6 SHAFT
DUCT INCREASES TO DESIGN SIZE AT
L-6 HIGH LEVEL

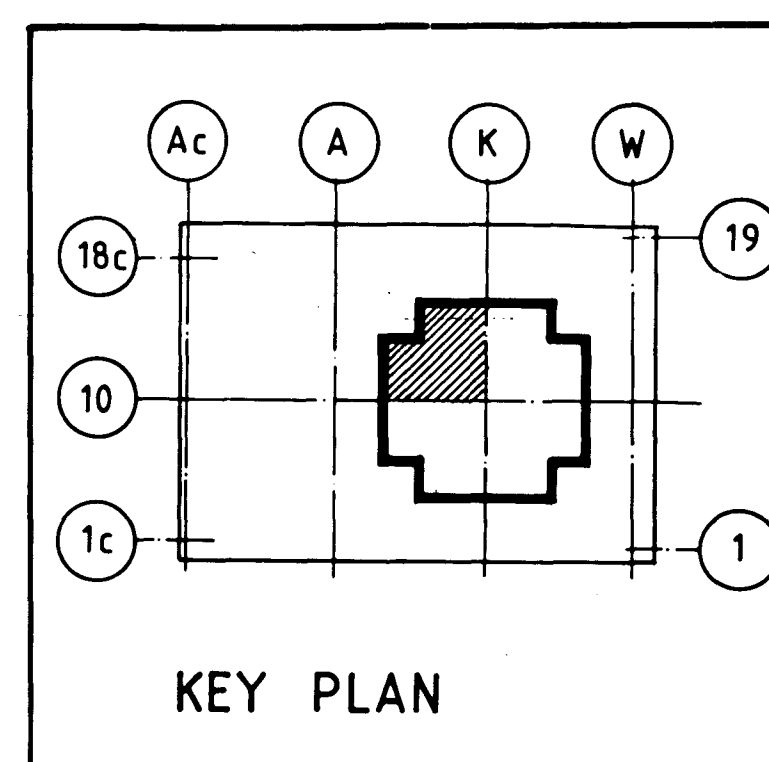

RECORD DRAWING

REVISION	DATE	DESCRIPTION
ONASSIS CARDIAC SURGERY CENTER		
Joannou & Paraskevalides (overseas) Ltd. civil engineering & building contractors		
J&P		
architects & health planners LLEWELYN-DAVIES WEEKS greek architects KAPSAMBELIS-STAMATIS structural & services engineers OVE ARUP & PARTNERS		
TITLE DUCT WORK, LEVEL 6 ZONE A		
DRAWN BY	K.P.	DRAWING No
DESIGN BY	M.S.	R-H007-1
CHECKED BY	N.P.	
SCALE	1:50	DATE JUNE 1991

T-1007-1