


10
9
8
7
6
5
4
3
1


A B C D E F G H J K

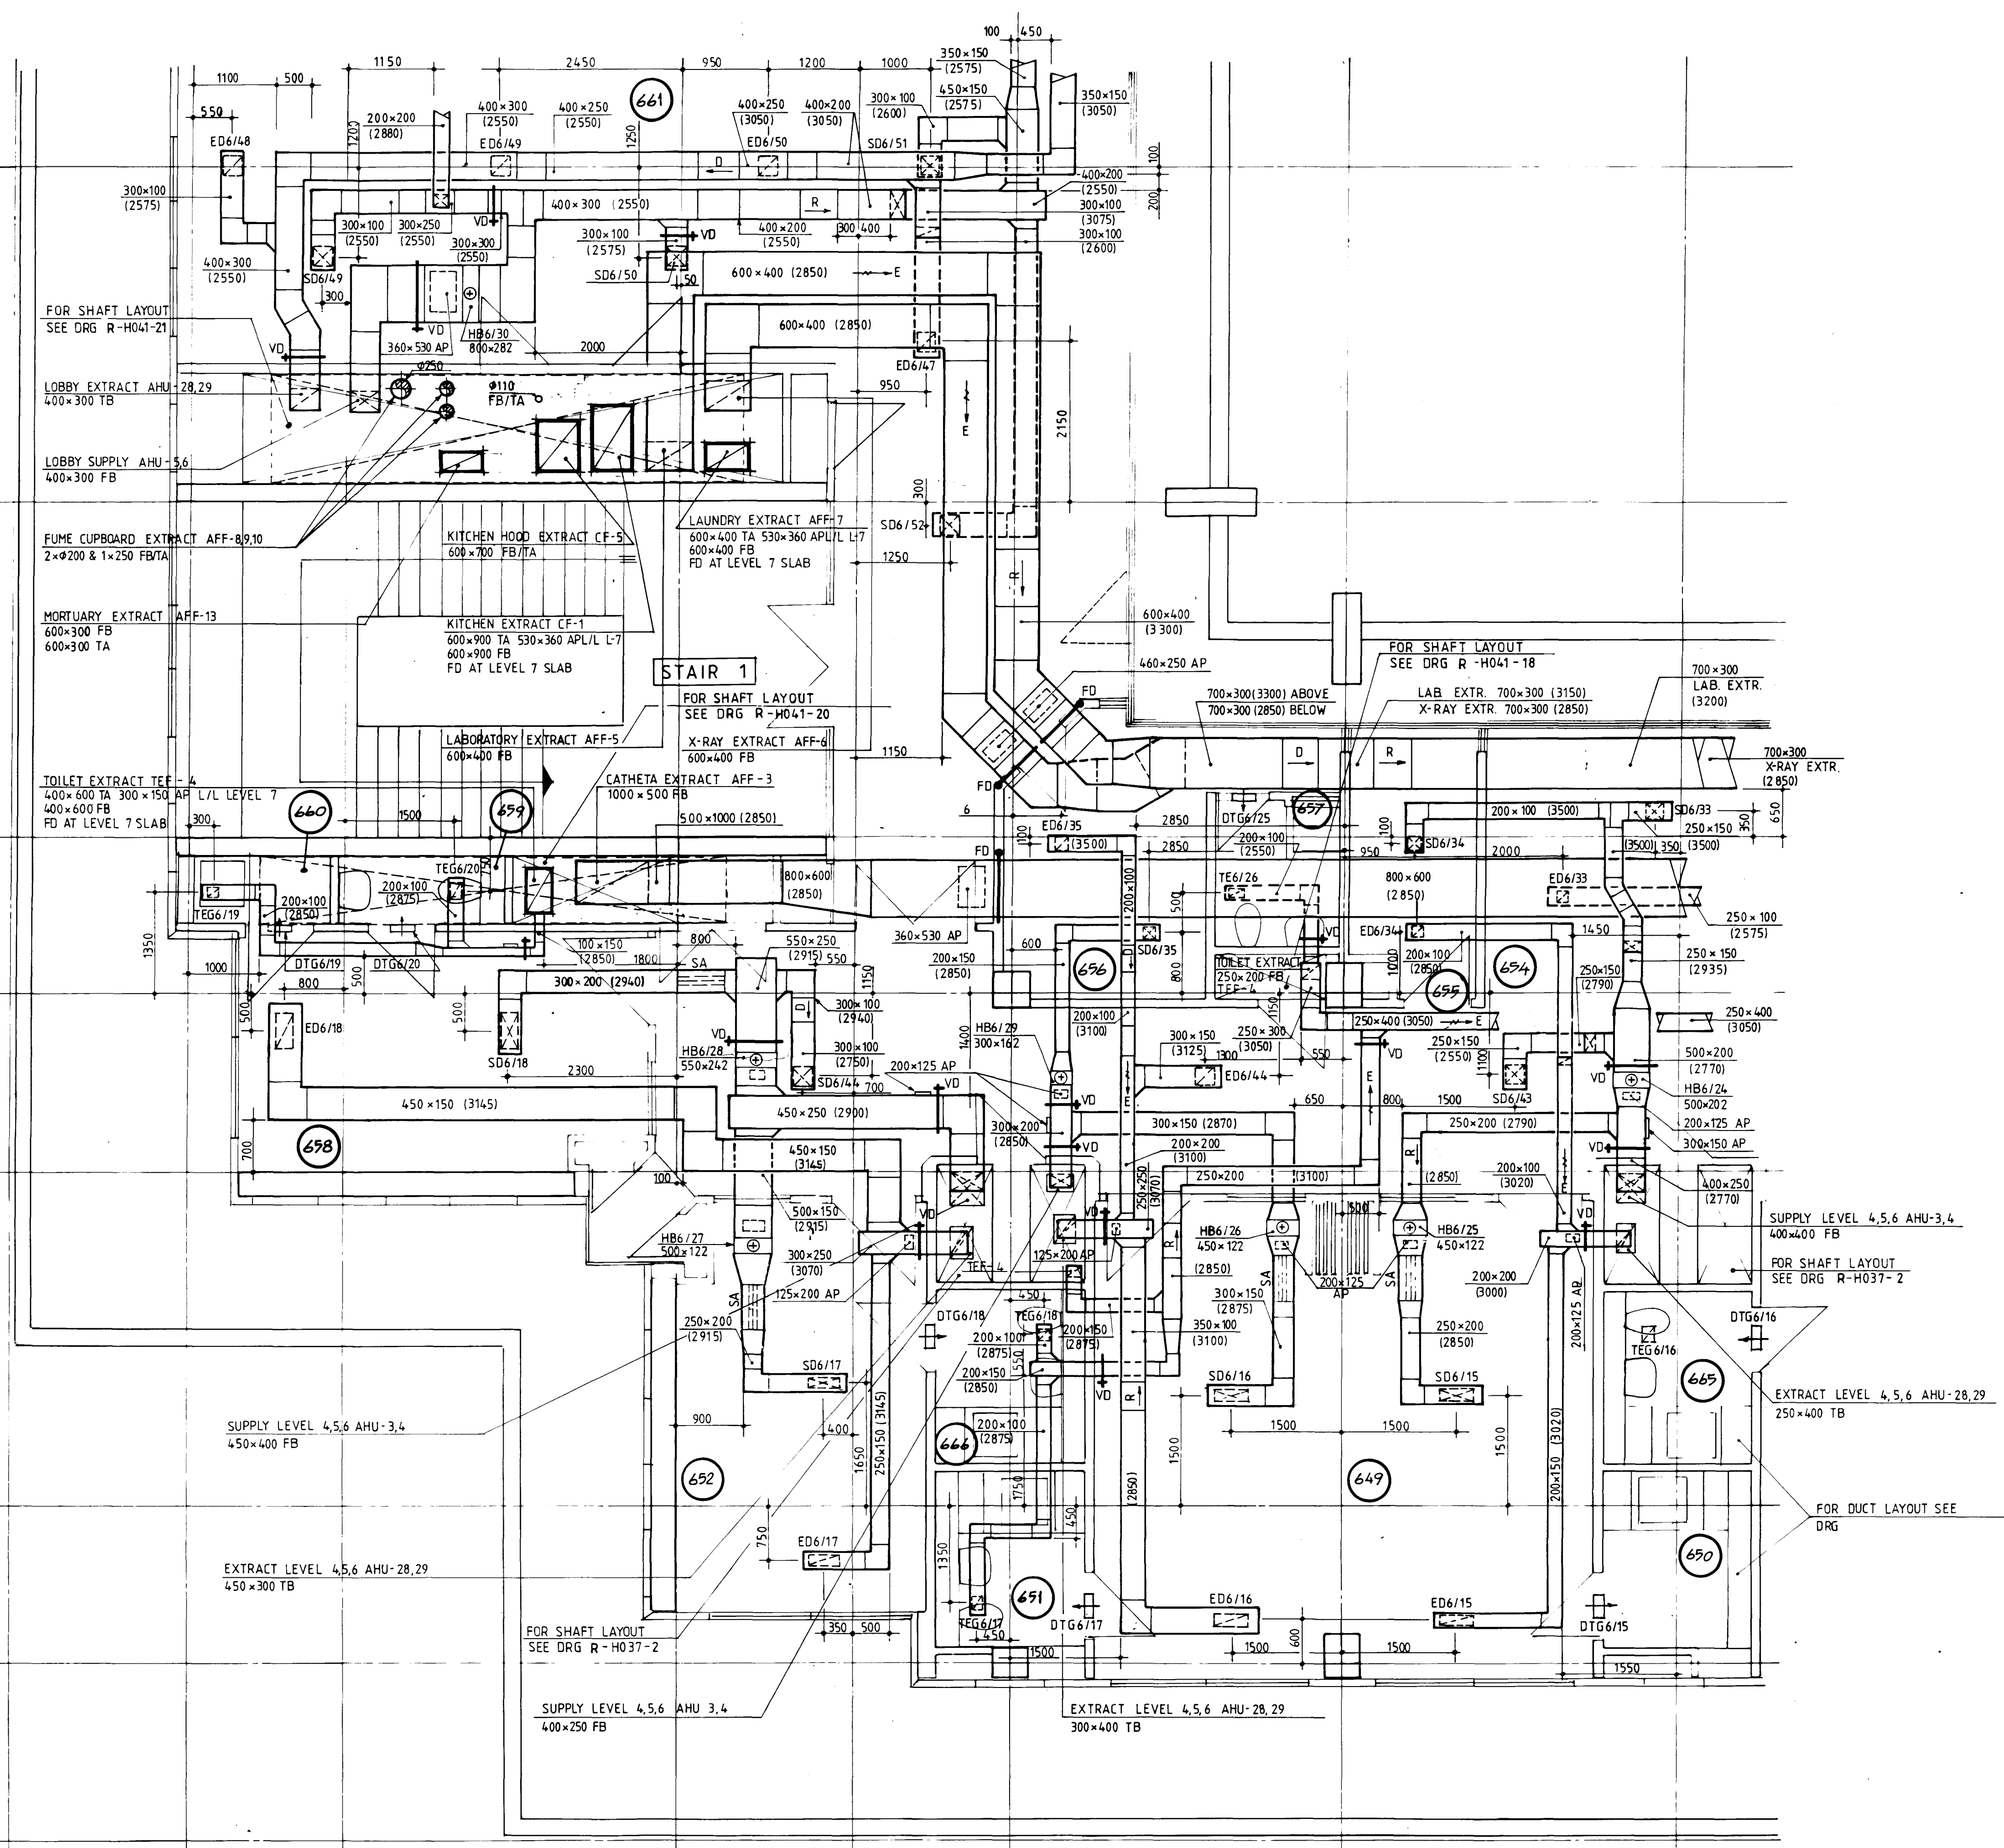

NOTE
1. FOR GENERAL NOTES SEE
DRG R-H007-1

RECORD DRAWING

REVISION	DATE	DESCRIPTION
ONASSIS CARDIAC SURGERY CENTER		
Joannou & Paraskevalides (overseas) Ltd. civil engineering & building contractors		
J&P		
architects & health planners LLEWELYN-DAVIES WEEKS greek architects KAPSAMBELIS-STAMATIS structural & services engineers OVE ARUP & PARTNERS		
TITLE DUCTWORK, LEVEL 6 ZONE D		
DRAWN BY	K.P.	DRAWING No
DESIGN BY	MS	R-H007-4
CHECKED BY	N.P.	
SCALE	1:50	DATE JULY 1997

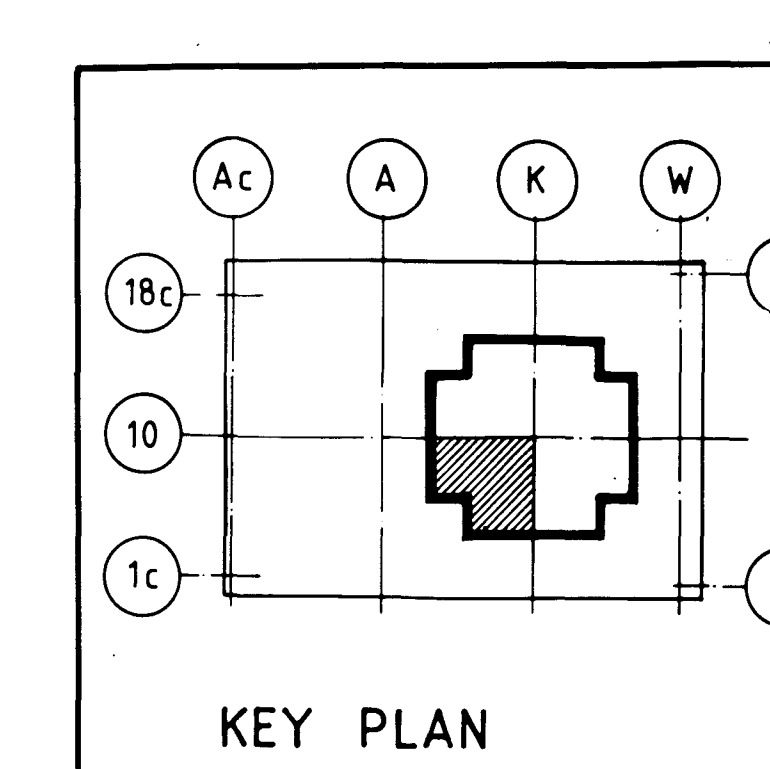

H007-4