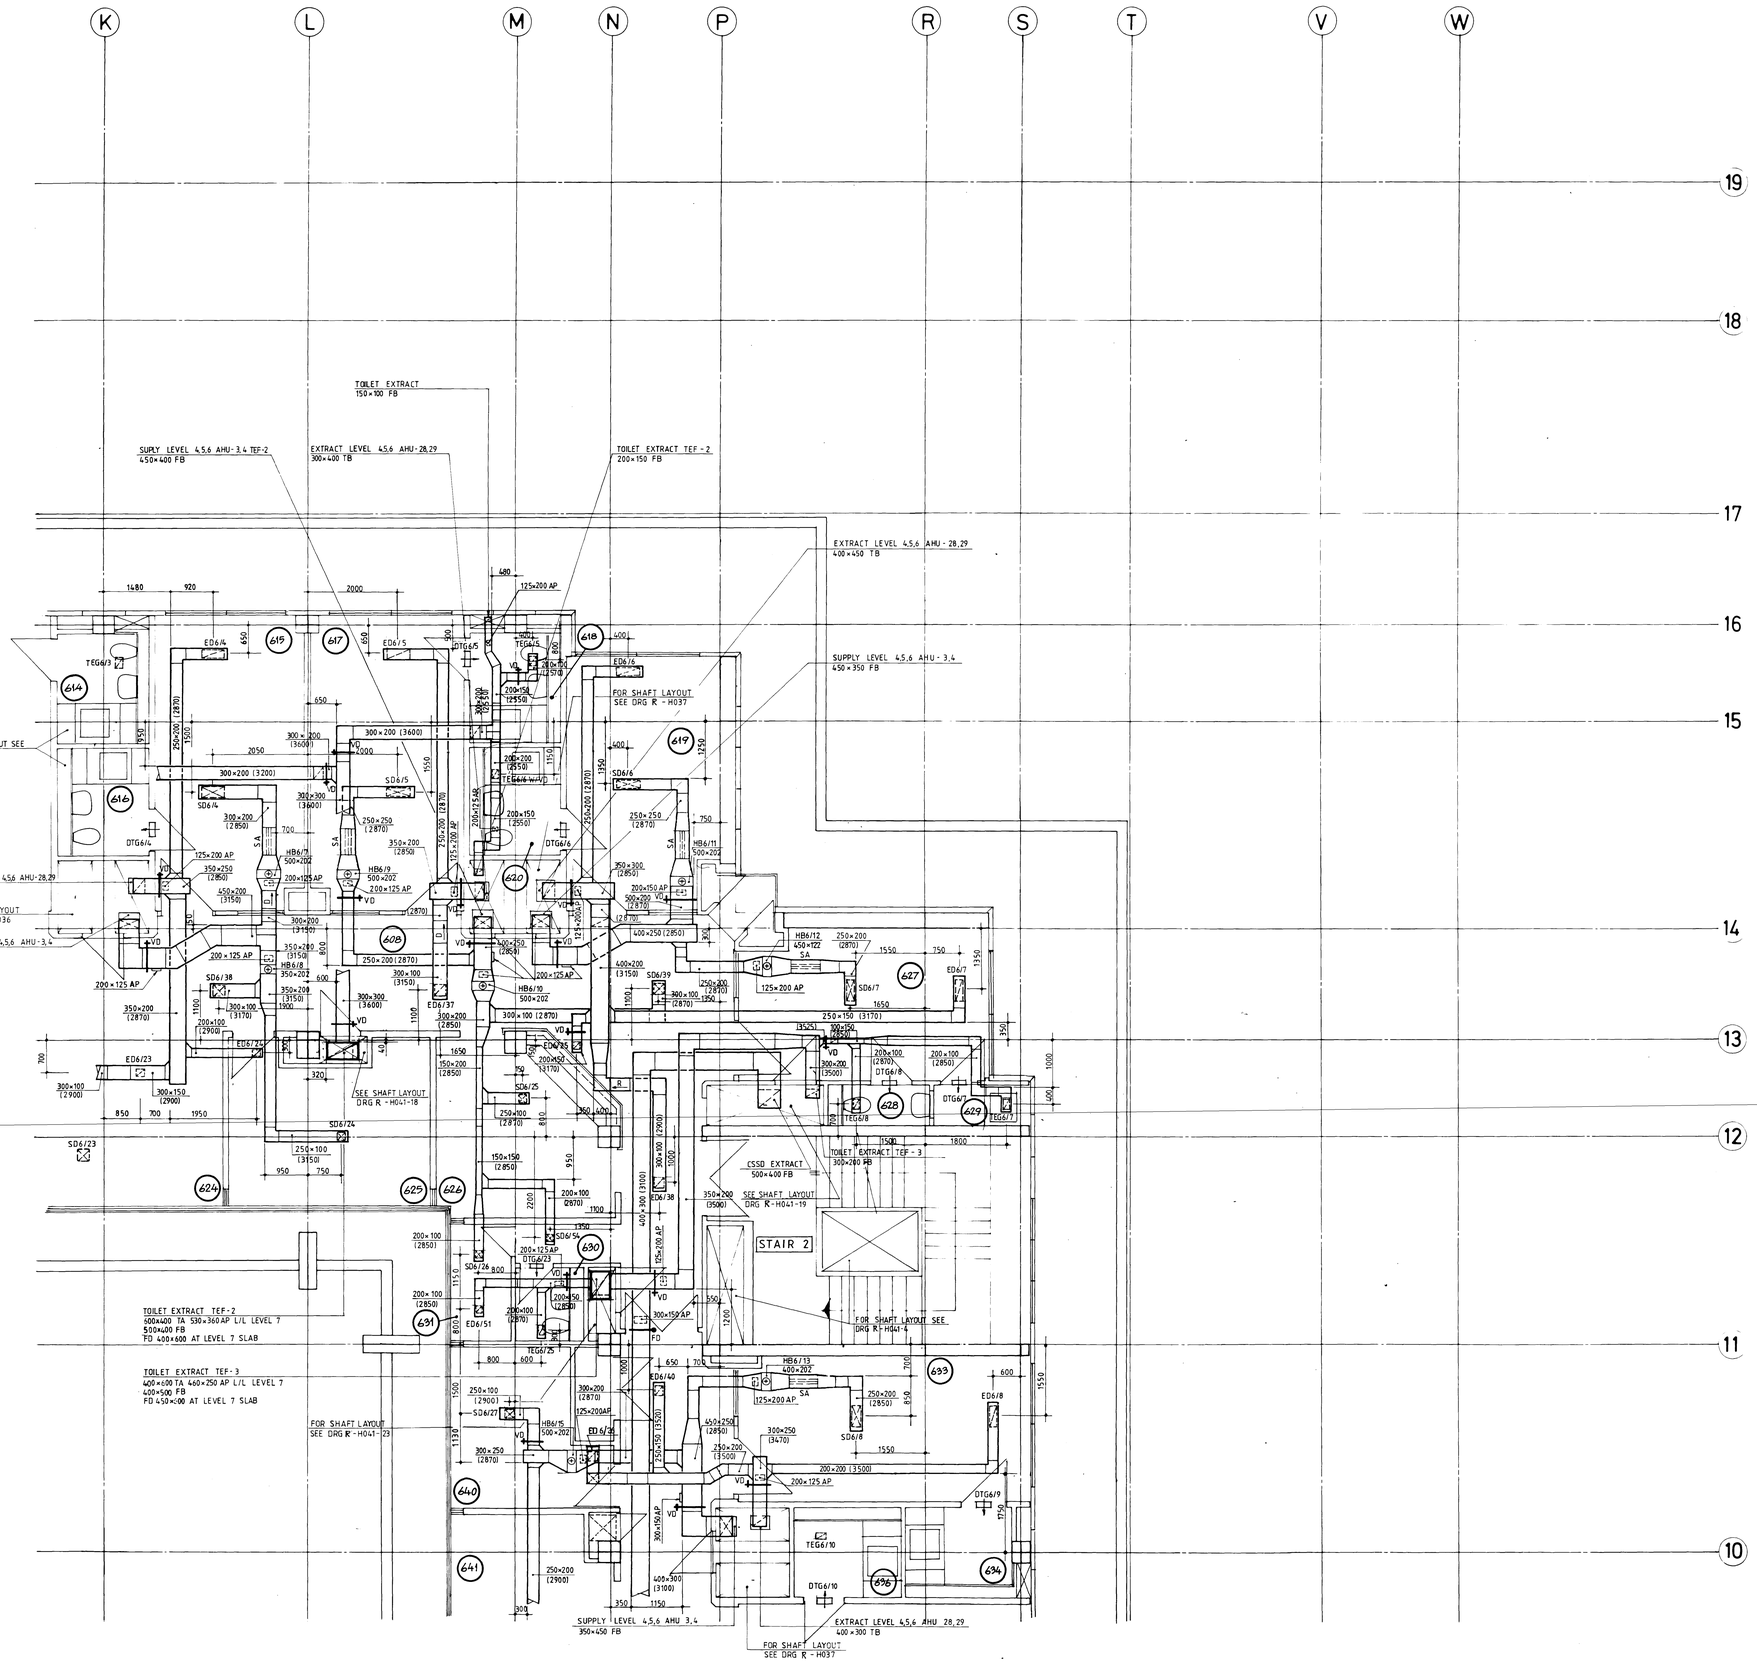

NOTE

1. FOR GENERAL NOTES SEE DRG R-H007-1

RECORD DRAWING

REVISION	DATE	DESCRIPTION

ONASSIS
CARDIAC SURGERY CENTER

Joannou & Paraskevaides (overseas) Ltd.
civil engineering & building contractors

J&P

architects & health planners LLEWELYN-DAVIES WEEKS
greek architects KAPSAMBELIS-STAMATIS
structural & services engineers OVE ARUP & PARTNERS

TITLE
DUCTWORK, LEVEL 6
ZONE B

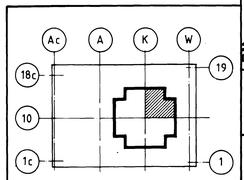

KEY PLAN

DRAWN BY	K.P	DRAWING No	R-H007-2
DESIGN BY	M.S		
CHECKED BY	N.P		
SCALE	1:50	DATE	JUNE 1991

H007-2

L-6 61